

Work Order ID 146153

May 06, 2016 2:36:18 PM

146153

Bel Special Modification
on D412-161-045 Page 1

U/R
DAS
22
9-89
16.05.06

Item ID: D3703-3
Revision ID: WAF 16-533
Item Name: Aft Corner Doubler

Accept

N900040100

Setup Start *NS1*
Stop *NS2*

Start Date: 5/9/2016 Start Qty: 6.00 *6*
Required Date: 5/11/2016 Req'd Qty: 6.00 *6*

Cust Item ID:
Customer:

Reference:

Approvals: Process Plan: SAC Date: 20160506 Tooling: _____ Date: _____
QC: _____ Date: _____ SPC (Y/N): _____ Date: _____

Run Start *NR1*
Stop *NR2*

Sequence ID/ Work Center ID	Operation Description	Set Up/ Run Hours	Tool ID	Tool #	Plan Code	Accept Qty	Reject Qty	Reject Number	Insp. Stamp
--------------------------------	--------------------------	----------------------	---------	--------	--------------	---------------	---------------	------------------	----------------

Draw Nbr	Revision Nbr
D3703	B W

100
100
Waterjet
FLOW CNC Waterjet

PROCEED AS PER MARK UPS - 0.00
FLOW WATER JET MINOR DEVIATION.
Memo 0.24
DAS 22 9-89

1-Cut as per Dwg D3703
Dwg Rev: B
Prog Rev: B

2- Deburr if necessary

6 16/05/09

110
110
QC
Quality Control

QC2- Inspect parts off machine FAI/FAIB 0.00
Memo 0.06

6 16/05/09

DQA: _____ Date: _____

**WORK ORDER NON-CONFORMANCE / UPDATE**

QA Closed: _____ Date: _____

Work Order update only ☐

Work Order: _____ Part No. _____ NCR No. _____		DISPOSITION Rework ☐ Scrap ☐ Use-as-is ☐ Suspected Unapproved ☐		AGAINST DEPARTMENT/PROCESS <table style="width:100%; border: none;"> <tr> <td style="border: none;">Skid-tube ☐</td> <td style="border: none;">Cross tube ☐</td> <td style="border: none;">Water Jet ☐</td> <td style="border: none;">Engineering ☐</td> </tr> <tr> <td style="border: none;">Machining ☐</td> <td style="border: none;">Small Fab ☐</td> <td style="border: none;">Prod. Eng. Coord. ☐</td> <td style="border: none;">Quality ☐</td> </tr> <tr> <td style="border: none;">Thermoforming ☐</td> <td style="border: none;">Finishing ☐</td> <td style="border: none;">Rec/Store/Packaging ☐</td> <td style="border: none;">Other ☐</td> </tr> <tr> <td style="border: none;">Large Fab ☐</td> <td style="border: none;">Composite ☐</td> <td style="border: none;">Supplier ☐</td> <td></td> </tr>
Date :		Step #:		QTY Effective :			MRB (QSI042) Approval																		
Description Work Order Deviation				Disposition																					
								Completed By																	
								Lead hand / Supervisor Approval Verification																	
								QC / QA Coordinator Approval																	
Root Cause		FAULT CATEGORY																							
Environment ☐ Design ☐ Doc/Data ☐ Equip/Tooling ☐ Handling/Pre ☐ Material ☐ Internal Transport ☐ Tribal Knowledge ☐ LOA ☐ Substation ☐ Past Expiry Date ☐ Misidentified ☐	No Re-verification ☐ Operator ☐ Offset/Setup ☐ Supplier ☐ Training ☐ Use for Testing ☐ Poor Information ☐ Rushing ☐ Product Improvement ☐ Process Improvement ☐ Manufacturing Process ☐ Past Due ☐	Pressure/Forced ☐ Bending ☐ Centre Not Concentric ☐ Cracks ☐ Crimp/Kink/Ripple/Wave ☐ Cuffs ☐ Crushing ☐ Heat Treat ☐ Wave/Twist in Tube ☐ Marks/Chatter ☐		Temperature/Cure ☐ Set-up ☐ BOM/Route ☐ Broken/Damage/Defect ☐ Inspection Incomplete/Unqualified ☐ Contamination ☐ Countersink ☐ Cut Too Short ☐ Instructions Incomplete/Unclear ☐ Drill Holes ☐		Power Loss/Surge ☐ Folio/Program ☐ Grain ☐ Weld ☐ Wrong Stock Pulled ☐ Out of Sequence ☐ Off-set ☐ Mislabeled ☐ Fit/Function ☐ Misaligned/off center ☐		Positioned Wrong ☐ Outside Dimensions ☐ Over/Under tolerance ☐ Part Incorrect ☐ Part Lost/Missing ☐ Part Moved ☐ Drawing ☐ Finish ☐ Misread ☐ Turning Sequence ☐																	
OTHER : ☐																									

Work Order ID 146153

May 06, 2016 2:36:18 PM

146153

Page 2

Item ID: D3703-3

Accept

N900040100Setup Start ***NS1***

Revision ID: URF 16-533

Item Name: Aft Corner Doubler

Stop ***NS2***

Start Date: 5/9/2016 Start Qty: 6.00

6

Cust Item ID:

Required Date: 5/11/2016 Req'd Qty: 6.00

6

Customer:

Reference:

Approvals: Process Plan: _____ Date: _____ Tooling: _____ Date: _____

Run Start ***NR1***

QC: _____ Date: _____ SPC (Y/N): _____ Date: _____

Stop ***NR2***

Sequence ID/ Work Center ID	Operation Description	Set Up/ Run Hours	Tool ID	Tool #	Plan Code	Accept Qty	Reject Qty	Reject Number	Insp. Stamp
--------------------------------	--------------------------	----------------------	---------	--------	--------------	---------------	---------------	------------------	----------------

120

QC8- Inspect parts - second check

0.00

120

QC

Memo

0.12

Quality Control

DAS
38

9-89

MAY 10 2016

130

Chemical Conversion Coat per QSI005 4.1

0.00

130

HandFinish

Memo

0.24

Hand Finishing

62 c of 11 16/05/12

140

QC7-Inspect Chemical Conversion Coat

0.00

140

QC

Memo

0.06

Quality Control

6

DAS
38

9-89

MAY 12 2016

DQA: _____ Date: _____



WORK ORDER NON-CONFORMANCE / UPDATE

QA Closed: _____ Date: _____

Work Order update only ☐

Work Order: _____ Part No. _____ NCR No. _____	DISPOSITION Rework ☐ Scrap ☐ Use-as-is ☐ Suspected Unapproved ☐	AGAINST DEPARTMENT/PROCESS <table style="width:100%; border: none;"> <tr> <td style="border: none;">Skid-tube ☐</td> <td style="border: none;">Cross tube ☐</td> <td style="border: none;">Water Jet ☐</td> <td style="border: none;">Engineering ☐</td> </tr> <tr> <td style="border: none;">Machining ☐</td> <td style="border: none;">Small Fab ☐</td> <td style="border: none;">Prod. Eng. Coord. ☐</td> <td style="border: none;">Quality ☐</td> </tr> <tr> <td style="border: none;">Thermoforming ☐</td> <td style="border: none;">Finishing ☐</td> <td style="border: none;">Rec/Store/Packaging ☐</td> <td style="border: none;">Other ☐</td> </tr> <tr> <td style="border: none;">Large Fab ☐</td> <td style="border: none;">Composite ☐</td> <td style="border: none;">Supplier ☐</td> <td></td> </tr>
Date :	Step #:	QTY Effective :		MRB (QSI042) Approval																	
Description Work Order Deviation		Disposition		Completed By																	
				Lead hand / Supervisor Approval Verification																	
				QC / QA Coordinator Approval																	
<table style="width:100%; border: none;"> <tr> <td style="width:25%; vertical-align: top;"> Root Cause Environment ☐ Design ☐ Doc/Data ☐ Equip/Tooling ☐ Handling/Pre ☐ Material ☐ Internal Transport ☐ Tribal Knowledge ☐ LOA ☐ Substation ☐ Past Expiry Date ☐ Misidentified ☐ </td> <td style="width:25%; vertical-align: top;"> ☐ No Re-verification ☐ Operator ☐ Offset/Setup ☐ Supplier ☐ Training ☐ Use for Testing ☐ Poor Information ☐ Rushing ☐ Product Improvement ☐ Process Improvement ☐ Manufacturing Process ☐ Past Due </td> <td style="width:25%; vertical-align: top;"> ☐ Pressure/Forced ☐ Bending ☐ Centre Not Concentric ☐ Cracks ☐ Crimp/Kink/Ripple/Wave ☐ Cuffs ☐ Crushing ☐ Heat Treat ☐ Wave/Twist in Tube ☐ Marks/Chatter </td> <td style="width:25%; vertical-align: top;"> FAULT CATEGORY ☐ Temperature/Cure ☐ Set-up ☐ BOM/Route ☐ Broken/Damage/Defect ☐ Inspection Incomplete/Unqualified ☐ Contamination ☐ Countersink ☐ Cut Too Short ☐ Instructions Incomplete/Unclear ☐ Drill Holes </td> <td style="width:25%; vertical-align: top;"> ☐ Power Loss/Surge ☐ Folio/Program ☐ Grain ☐ Weld ☐ Wrong Stock Pulled ☐ Out of Sequence ☐ Off-set ☐ Mislabeled ☐ Fit/Function ☐ Misaligned/off center </td> <td style="width:25%; vertical-align: top;"> ☐ Positioned Wrong ☐ Outside Dimensions ☐ Over/Under tolerance ☐ Part Incorrect ☐ Part Lost/Missing ☐ Part Moved ☐ Drawing ☐ Finish ☐ Misread ☐ Turning Sequence </td> </tr>

☐ OTHER : _____																					

Work Order ID 146153

May'06, 2016 2:36:18 PM

146153

Page 3

Item ID: D3703-3 Accept ***N900040100*** Setup Start ***NS1***
Revision ID: URF 16-533 Stop ***NS2***
Item Name: Aft Corner Doubler
Start Date: 5/9/2016 Start Qty: 6.00 ***6*** Cust Item ID:
Required Date: 5/11/2016 Req'd Qty: 6.00 ***6*** Customer:
Reference:

Approvals: Process Plan: _____ Date: _____ Tooling: _____ Date: _____ Run Start ***NR1***
QC: _____ Date: _____ SPC (Y/N): _____ Date: _____ Stop ***NR2***

Sequence ID/ Work Center ID	Operation Description	Set Up/ Run Hours	Tool ID	Tool #	Plan Code	Accept Qty	Reject Qty	Reject Number	Insp. Stamp
150	Identify as per dwg & Stock Location: _____	0.00							
150	Pat D - Prelim Office								
Packaging	Memo	0.06							
Packaging	Quarantine								
160	QC21- Final Inspection - Work Order Release	0.00							
160									
QC	Memo	0.60							
Quality Control									

MLJ MAY 24 2016

DQA: _____ Date: _____



WORK ORDER NON-CONFORMANCE / UPDATE

QA Closed: _____ Date: _____

Work Order update only ☐

Work Order: _____ Part No. _____ NCR No. _____	DISPOSITION Rework ☐ Scrap ☐ Use-as-is ☐ Suspected Unapproved ☐	AGAINST DEPARTMENT/PROCESS Skid-tube ☐ Machining ☐ Thermoforming ☐ Large Fab ☐ Cross tube ☐ Small Fab ☐ Finishing ☐ Composite ☐ Water Jet ☐ Prod. Eng. Coord. ☐ Rec/Store/Packaging ☐ Supplier ☐ Engineering ☐ Quality ☐ Other ☐			
Date :	Step #:	QTY Effective :		MRB (QSI042) Approval	
Description Work Order Deviation		Disposition		Completed By	
				Lead hand / Supervisor Approval Verification	
				QC / QA Coordinator Approval	
Root Cause Environment ☐ Design ☐ Doc/Data ☐ Equip/Tooling ☐ Handling/Pre ☐ Material ☐ Internal Transport ☐ Tribal Knowledge ☐ LOA ☐ Substation ☐ Past Expiry Date ☐ Misidentified ☐ No Re-verification ☐ Operator ☐ Offset/Setup ☐ Supplier ☐ Training ☐ Use for Testing ☐ Poor Information ☐ Rushing ☐ Product Improvement ☐ Process Improvement ☐ Manufacturing Process ☐ Past Due ☐		FAULT CATEGORY Pressure/Forced ☐ Bending ☐ Centre Not Concentric ☐ Cracks ☐ Crimp/Kink/Ripple/Wave ☐ Cuffs ☐ Crushing ☐ Heat Treat ☐ Wave/Twist in Tube ☐ Marks/Chatter ☐ Temperature/Cure ☐ Set-up ☐ BOM/Route ☐ Broken/Damage/Defect ☐ Inspection Incomplete/Unqualified ☐ Contamination ☐ Countersink ☐ Cut Too Short ☐ Instructions Incomplete/Unclear ☐ Drill Holes ☐ Power Loss/Surge ☐ Folio/Program ☐ Grain ☐ Weld ☐ Wrong Stock Pulled ☐ Out of Sequence ☐ Off-set ☐ Misabeled ☐ Fit/Function ☐ Misaligned/off center ☐ Positioned Wrong ☐ Outside Dimensions ☐ Over/Under tolerance ☐ Part Incorrect ☐ Part Lost/Missing ☐ Part Moved ☐ Drawing ☐ Finish ☐ Misread ☐ Turning Sequence ☐			
OTHER : ☐					

Picklist Print

May 06, 2016 2:36:22 PM

Page 1

Work Order ID: 146153

146153

Parent Item: D3703-3

D3703-3

Parent Item Name: Aft Corner Doubler

Start Date: 5/9/2016

Required Date: 5/11/2016

Start Qty: 6.00

Required Qty: 6.00

Comments: IPP Rev:A 08-04-24 new issue DD verified by:EC
13.01.15 AS PER DWG REV.B DD VERF:JLM

IPP REV:B

Component Item ID/ Item Name	Replacement Item ID	Mfg/ Purch	Bin Item	Primary Location	Last Location	Route Seq ID	Unit of Measure	Qty on Hand	Qty per Kit	Total Qty	Qty Issued	Date Issued	Status
M6061T6S.063		Purchased	No			100	sf	528.1830	1.19	7.515789			
M6061T6S 063									**				
6061-T6 .063 Sheet													

Location

Loc Qty

Loc Code

MAT021

192.183

M132358

44.954

M133511

55.9

M134377

91.329

TPI

336

M134496

192

M134604

144

Under Review Notification

Raised By: M. BELLAVANCE

Product #: D412-761-045

Date: 16.02.25


Product Name: LARGE BUBBLE WINDOW KIT, LH

Part Number (D-Part and 9-Digit)	Drawing/Document & Current Affected Revision	"Y" or "N" Required for Each Part							Reserved ECN Log Number	Instructions Relevant to Each Part
		HOLD SHIPMENT	Red Tag/Quarantine Stock	Advise Customers	Stop Production	Re-Work Stock	IPP Under Review	Product Specifications Under Review		
D3703-3	D3703 Rev. B	N	Y	N	Y	N	Y	N	16-533	See below.
D412-761-045	IIN-D412-761 Rev.	N	Y	N	Y	N	Y	N	16-533	See below.


Description of Issue:

Current stock OK to ship to customers other than Bell Helicopter Mirabel.


If shipping to Bell Helicopter Mirabel: must ship D412-761-045 with D3703-3 modified as per attached. Eng. to sign off deviations on W/Os.

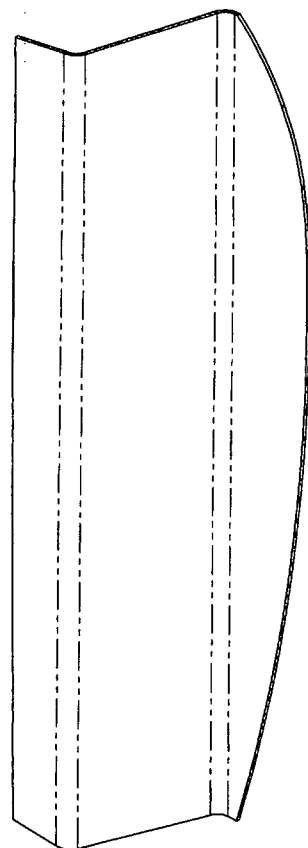

D3703-1 AFT DOUBLER

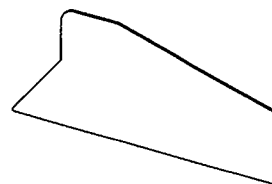

D3703-5 AFT CAP

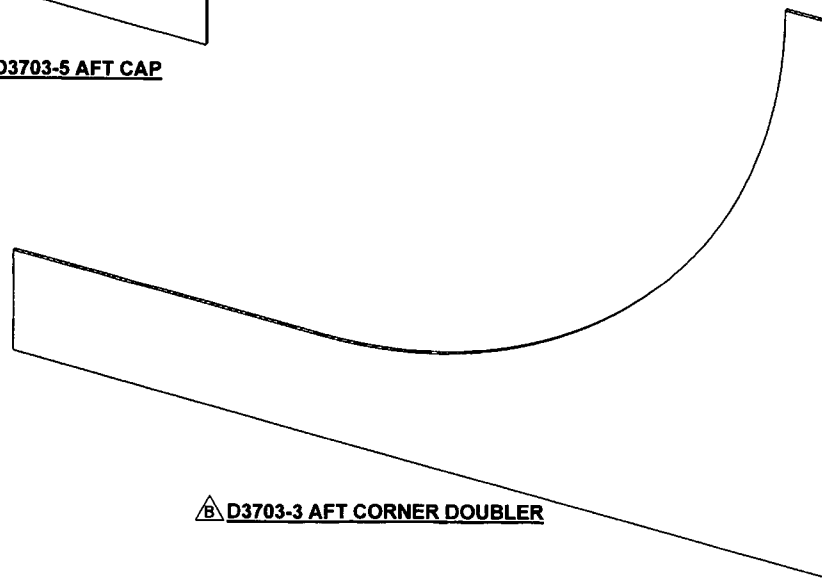

D3703-3 AFT CORNER DOUBLER


NOTES:

- 1) MATERIAL: 6061-T6 (OR 6061-T62) ALUMINUM SHEET, 0.063 THICK
PER AMS-QQ-A-250/11 OR AMS 4025 OR AMS 4027
(REF. DART SPEC. M6061T6S.063)
- 2) FINISH: CHEMICAL CONVERSION COAT PER DART QSI 005 4.1
- 3) TOLERANCES: PER DART QSI 018 UNLESS OTHERWISE NOTED
- 4) UNITS: INCHES UNLESS OTHERWISE NOTED
- 5) BREAK SHARP EDGES: 0.005 TO 0.010 MAX
- 6) IDENTIFICATION: IDENTIFY WITH DART P/N "D3703-X" AND B/N "BXXXXX" PER DART QSI 044 6.1 (PERMANENT PAINT MARKER)
- 7) WEIGHT: D3703-1 = 0.56 lbs, D3703-3 = 0.23 lbs, D3703-5 = 0.03 lbs
- 8) MANUFACTURE PART FROM "D3703-1F.DXF" FILE


RELEASED
2013-01-14

B	REVISED D3703-3/-5. REASON: PAR12-188/CIR12-4.	MB	12.12.06
A	NEW ISSUE	MB	08.04.30
REV.	DESCRIPTION	BY	DATE
DESIGN			
DRAWN			
CHECKED			
MFG. APPR.			
APPROVED			
DE APPR.			
DATE	12.12.06		

DART AEROSPACE LTD HAWKESBURY, ONTARIO, CANADA	
DRAWING NO. D3703	REV. B
TITLE AFT DOUBLER	SCALE NTS
COPYRIGHT © 2008 BY DART AEROSPACE LTD THIS DOCUMENT IS PRIVATE AND CONFIDENTIAL AND IS SUPPLIED ON THE EXPRESS CONDITION THAT IT IS NOT TO BE USED FOR ANY PURPOSE OR COPIED OR COMMUNICATED TO ANY OTHER PERSON WITHOUT WRITTEN PERMISSION FROM DART AEROSPACE LTD.	

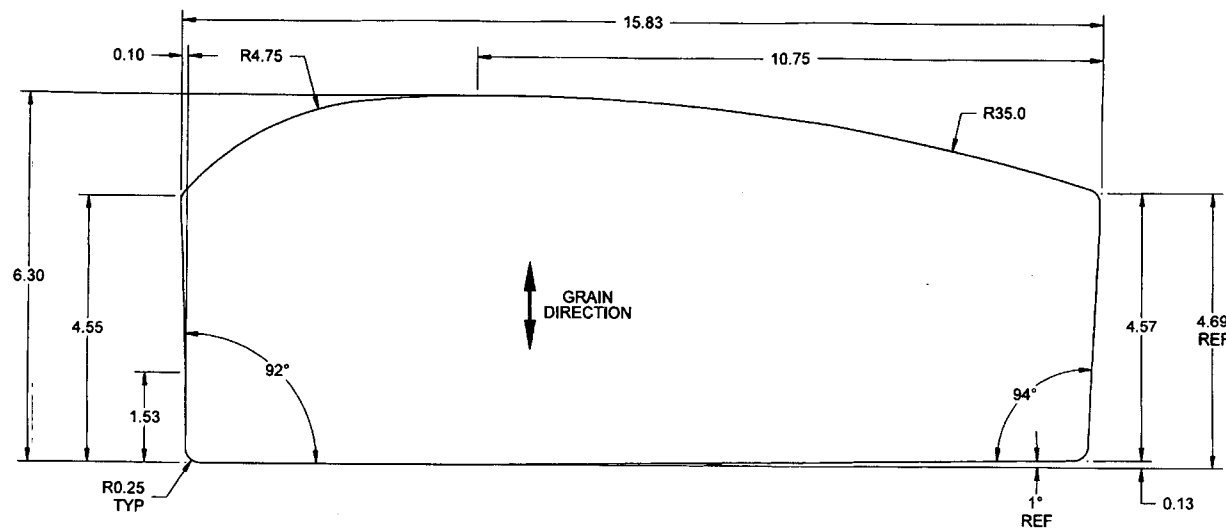


D3703-1F AFT DOUBLER FLAT PATTERN

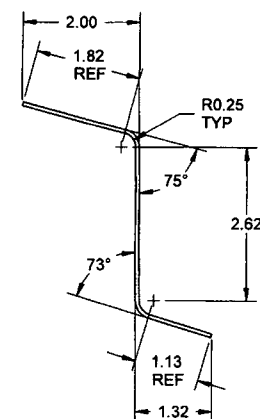

**D3703-1 AFT DOUBLER
(MAKE FROM D3703-1F)**

RELEASED
2013-01-14


DESIGN		DART AEROSPACE LTD	
DRAWN		HAWKESBURY, ONTARIO, CANADA	
CHECKED		DRAWING NO.	REV. B
MFG. APPR.		D3703	SHEET 2 OF 4
APPROVED		TITLE	SCALE
DE APPR.		AFT DOUBLER	NTS
DATE	12.12.06	COPYRIGHT © 2008 BY DART AEROSPACE LTD THIS DOCUMENT IS PRIVATE AND CONFIDENTIAL AND IS SUPPLIED ON THE EXPRESS CONDITION THAT IT IS NOT TO BE USED FOR ANY PURPOSE OR COPIED OR COMMUNICATED TO ANY OTHER PERSON WITHOUT WRITTEN PERMISSION FROM DART AEROSPACE LTD.	

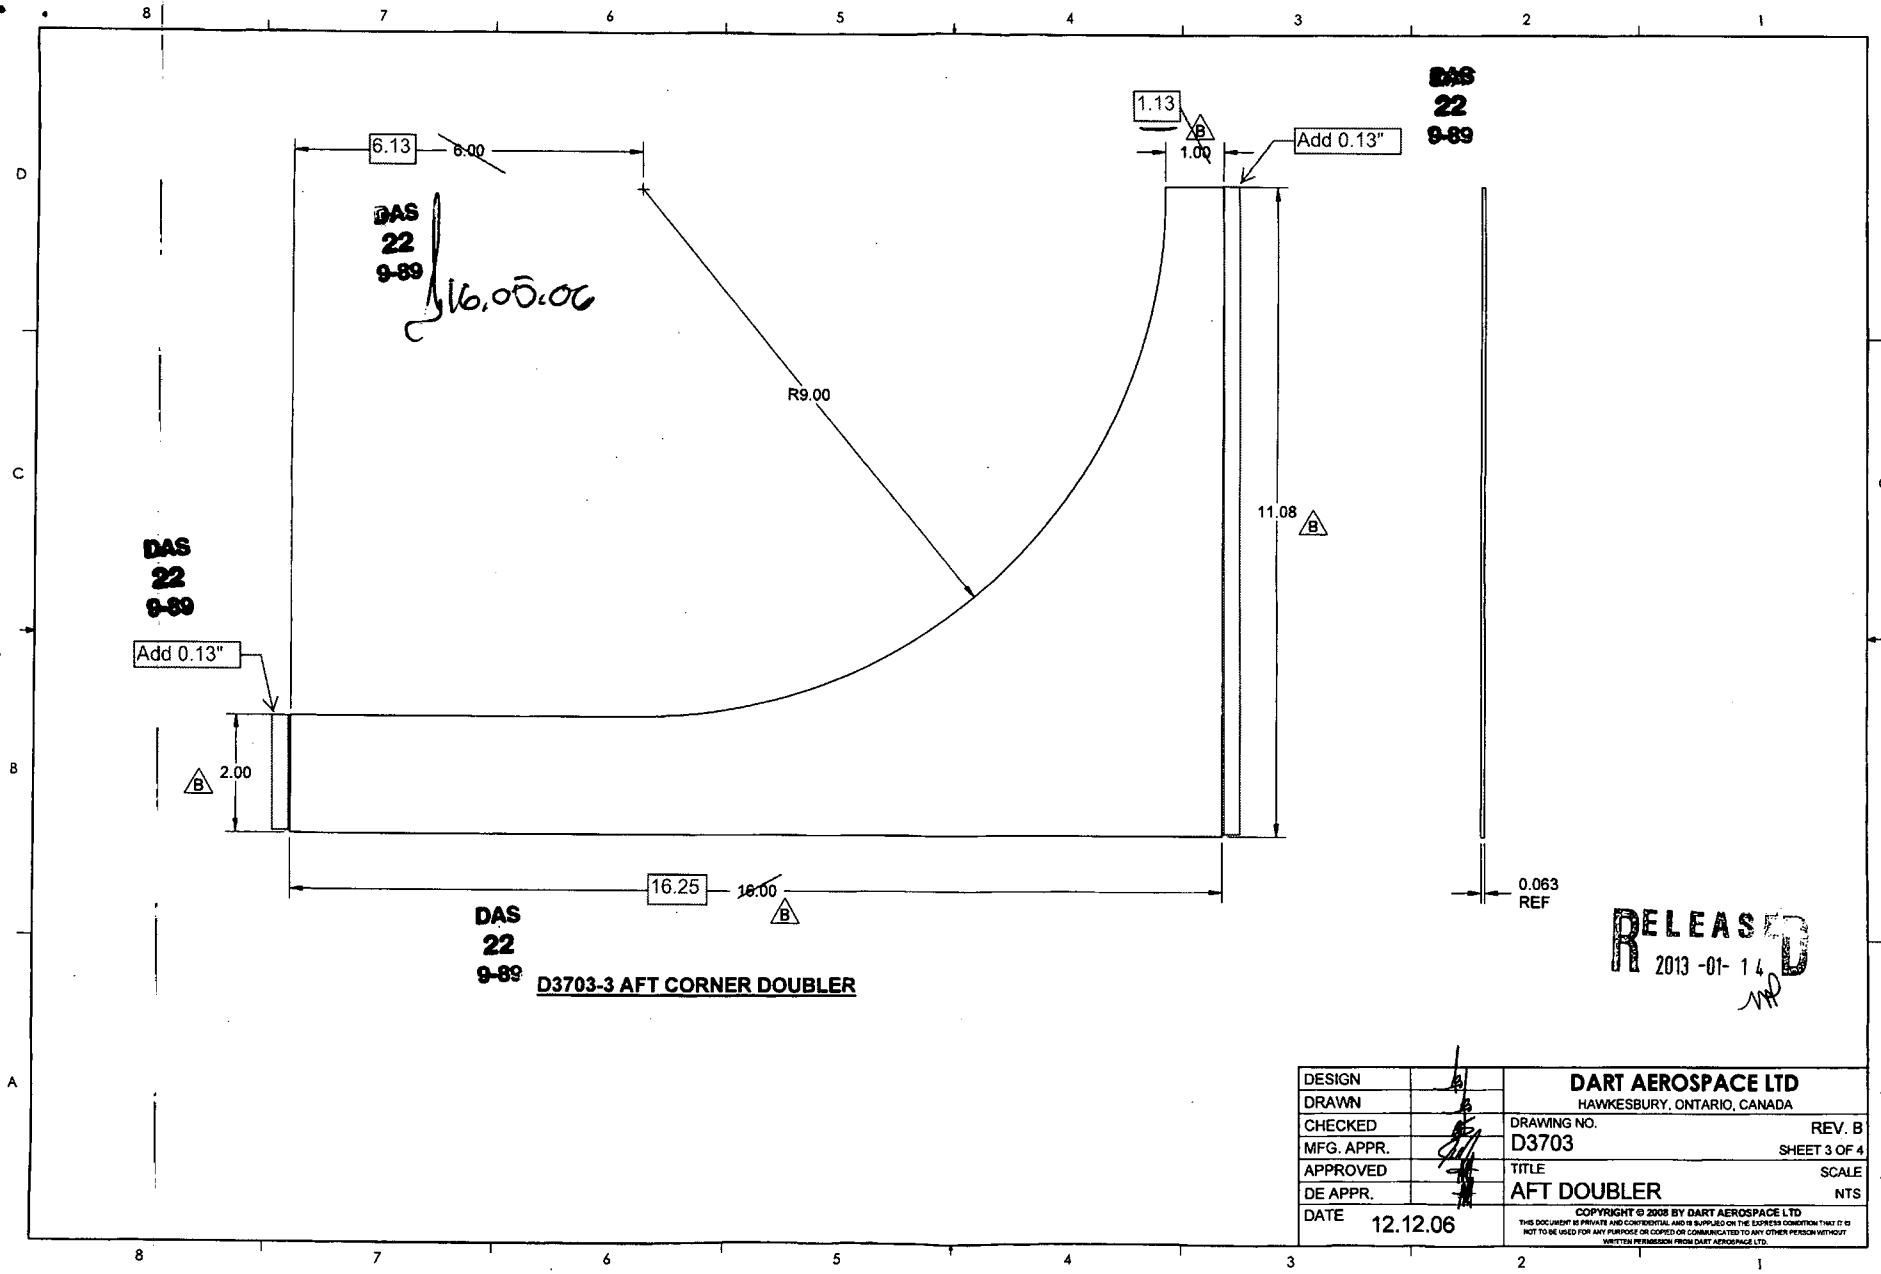

**DAS
22
9-89**
D3703-3 AFT CORNER DOUBLER

RELEASED
2013-01-14
MD

DESIGN		DART AEROSPACE LTD	
DRAWN		HAWKESBURY, ONTARIO, CANADA	
CHECKED		DRAWING NO.	REV. B
MFG. APPR.		D3703	SHEET 3 OF 4
APPROVED		TITLE	SCALE
DE APPR.		AFT DOUBLER	NTS
DATE	12.12.06	COPYRIGHT © 2008 BY DART AEROSPACE LTD THIS DOCUMENT IS PRIVATE AND CONFIDENTIAL AND IS SUPPLIED ON THE EXPRESS CONDITION THAT IT IS NOT TO BE USED FOR ANY PURPOSE OR COPIED OR COMMUNICATED TO ANY OTHER PERSON WITHOUT WRITTEN PERMISSION FROM DART AEROSPACE LTD.	

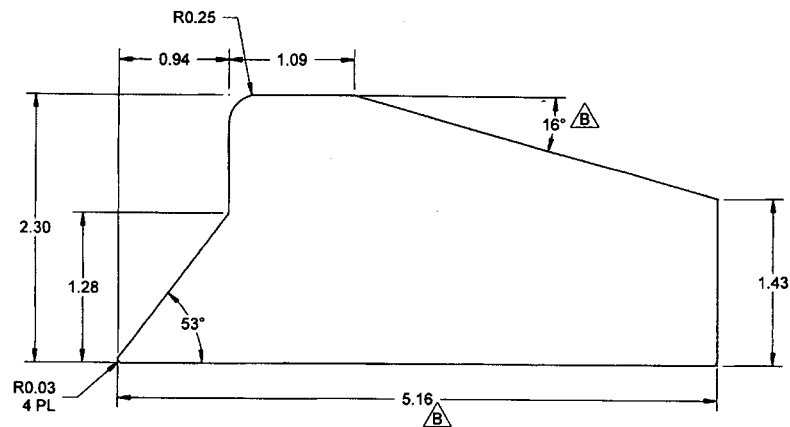

D3703-5 AFT CAP

RELEASED
2013-01-14

DESIGN		DART AEROSPACE LTD	
DRAWN		HAWKESBURY, ONTARIO, CANADA	
CHECKED		DRAWING NO. D3703	REV. B
MFG. APPR.		SHEET 4 OF 4	
APPROVED		TITLE	SCALE
DE APPR.		AFT DOUBLER	NTS
DATE	12.12.06	COPYRIGHT © 2008 BY DART AEROSPACE LTD THIS DOCUMENT IS PRIVATE AND CONFIDENTIAL AND IS SUPPLIED ON THE EXPRESS CONDITION THAT IT IS NOT TO BE USED FOR ANY PURPOSE OR COPIED OR COMMUNICATED TO ANY OTHER PERSON WITHOUT WRITTEN PERMISSION FROM DART AEROSPACE LTD.	

